

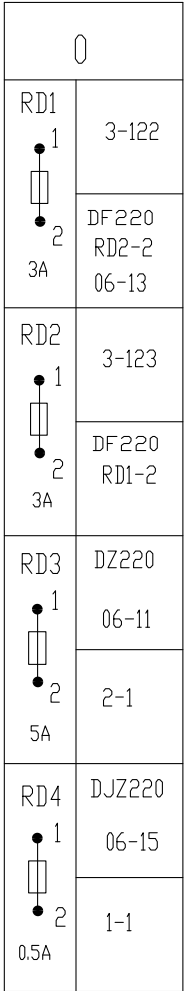


| 5  | FBJ          |    |       | 4  | DBJ           |    |                 | 3   | 2DQJ            |     |           | 2  | 1DQJ            |    |               | 1  | 变压器 BB          |                 |  |
|----|--------------|----|-------|----|---------------|----|-----------------|-----|-----------------|-----|-----------|----|-----------------|----|---------------|----|-----------------|-----------------|--|
|    | JPXC-1000    |    |       |    | JPXC-1000     |    |                 |     | JYJXC-135/220   |     |           |    | JWJXC-H125/0.44 |    |               |    | BD1-7           |                 |  |
| 72 | 02-5         | 82 | 03-6  | 72 | 02-4          | 82 | 03-4            |     |                 |     |           |    |                 |    |               |    |                 |                 |  |
| 71 | 4-71<br>6-71 | 81 | 03-5  | 71 | 5-71<br>05-17 | 81 | 03-3            | 132 | 4-1             | 142 | 1<br>8-31 | 32 | 3-3             | 42 | 3-2           |    |                 |                 |  |
| 73 |              | 83 |       | 73 |               | 83 |                 | 131 | 2-13            | 141 | 2-4       | 31 | KZ 41<br>6-52   | 41 | KZ 31<br>06-1 |    |                 |                 |  |
| 52 |              | 62 | 05-15 | 52 |               | 62 | 05-12           | 133 | 5-4             | 143 | 4<br>7-31 | 33 | 9-42            | 43 | 9-63          |    |                 |                 |  |
| 51 |              | 61 | 05-14 | 51 |               | 61 | 05-11           |     |                 |     |           |    |                 |    |               |    |                 |                 |  |
| 53 |              | 63 | 05-16 | 53 |               | 63 | 05-13           | 112 | 03-15           | 122 | RD1-1     | 12 | 2               | 22 | 3-121         |    |                 |                 |  |
| 32 |              | 42 |       | 32 |               | 42 |                 |     |                 |     |           |    |                 |    |               |    |                 |                 |  |
| 31 |              | 41 |       | 31 |               | 41 |                 | 111 | 2-11            | 121 | 2-22      | 11 | 3-111           | 21 | 03-18         |    |                 |                 |  |
| 33 |              | 43 |       | 33 |               | 43 |                 |     |                 |     |           |    |                 |    |               |    |                 |                 |  |
| 12 |              | 22 |       | 12 |               | 22 |                 | 113 | 03-16           | 123 | RD2-1     | 13 | C-2<br>3-131    | 23 |               |    |                 |                 |  |
| 11 |              | 21 |       | 11 |               | 21 |                 |     |                 |     |           |    |                 |    |               |    |                 |                 |  |
| 13 |              | 23 |       | 13 |               | 23 |                 | 3   | 2-32            | 4   | 143       | 3  | 03-10           | 4  | 3-141         |    |                 |                 |  |
| 3  | 2            | 4  | 3-133 | 3  | 2             | 4  | 1-4<br>5-1      | 1   | 142             | 2   | 2-42      | 1  | RD3-2<br>9-31   | 2  | 12<br>9-33    | 3  | R-1             | 4<br>C-1<br>4-4 |  |
| 1  | 4-4          | 2  | 3     | 1  | 3-132         | 2  | 3               |     |                 |     |           |    |                 |    |               | 1  | RD4-2           | 2<br>06-17      |  |
| 10 |              |    |       | 9  | BXZ           |    |                 | 8   | FCJ             |     |           | 7  | DCJ             |    |               | 6  | SJ              |                 |  |
|    |              |    |       |    |               |    |                 |     | JWXC-1700       |     |           |    | JWXC-1700       |    |               |    | JWXC-1700       |                 |  |
| 72 |              | 82 |       | 72 |               | 82 |                 | 72  |                 | 82  |           | 72 |                 | 82 |               | 72 | 02-6            | 82              |  |
| 71 |              | 81 |       | 71 |               | 81 |                 | 71  |                 | 81  |           | 71 |                 | 81 |               | 71 | 5-71<br>05-18   | 81              |  |
| 73 |              | 83 |       | 73 |               | 83 |                 | 73  |                 | 83  |           | 73 |                 | 83 |               | 73 |                 | 83              |  |
| 52 |              | 62 |       | 52 |               | 62 |                 | 52  |                 | 62  |           | 52 |                 | 62 |               | 52 | KZ 2-31<br>9-41 | 62              |  |
| 51 |              | 61 |       | 51 | 04-1          | 61 |                 | 51  |                 | 61  |           | 51 |                 | 61 |               | 51 | 03-8            | 61              |  |
| 53 |              | 63 |       | 53 | 04-2          | 63 | 2-43            | 53  |                 | 63  |           | 53 |                 | 63 |               | 53 |                 | 63              |  |
| 32 |              | 42 |       | 32 |               | 42 | 2-33            | 32  | KF 7-32<br>9-43 | 42  |           | 32 | KF 06-3<br>8-32 | 42 |               | 32 |                 | 42              |  |
| 31 |              | 41 |       | 31 | 2-1           | 41 | KZ 6-52<br>06-2 | 31  | 3-142           | 41  |           | 31 | 3-143           | 41 |               | 31 |                 | 41              |  |
| 33 |              | 43 |       | 33 | 2-2           | 43 | KF 8-32<br>06-4 | 33  |                 | 43  |           | 33 |                 | 43 |               | 33 |                 | 43              |  |
| 12 |              | 22 |       | 12 |               | 22 |                 | 12  |                 | 22  |           | 12 |                 | 22 |               | 12 |                 | 22              |  |
| 11 |              | 21 |       | 11 |               | 21 |                 | 11  |                 | 21  |           | 11 |                 | 21 |               | 11 |                 | 21              |  |
| 13 |              | 23 |       | 13 |               | 23 |                 | 13  |                 | 23  |           | 13 |                 | 23 |               | 13 |                 | 23              |  |
| 3  |              | 4  |       | 3  |               | 4  |                 | 3   | 2               | 4   | 01-13     | 3  | 2               | 4  | 01-12         | 3  | 2               | 4<br>01-11      |  |
| 1  |              | 2  |       | 1  |               | 2  |                 | 1   | 01-3            | 2   | 3         | 1  | 01-2            | 2  | 3             | 1  | 01-1            | 2<br>3          |  |

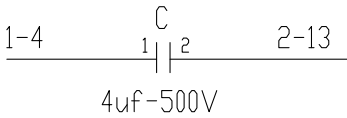

| 06 |                 | 05 |                 | 04 |      | 03 |       | 02 |      | 01 |     |
|----|-----------------|----|-----------------|----|------|----|-------|----|------|----|-----|
| 1  | KZ 2-41 2       | 1  |                 | 1  | 9-51 | 1  |       | 1  |      | 1  | 6-1 |
| 2  | KZ 9-41 1       | 2  |                 | 2  | 9-53 | 2  |       | 2  |      | 2  | 7-1 |
| 3  | KF 7-32 4       | 3  |                 | 3  |      | 3  | 4-81  | 3  |      | 3  | 8-1 |
| 4  | KF 9-43 3       | 4  |                 | 4  |      | 4  | 4-82  | 4  | 4-72 | 4  |     |
| 5  |                 | 5  |                 | 5  |      | 5  | 5-81  | 5  | 5-72 | 5  |     |
| 6  |                 | 6  |                 | 6  |      | 6  | 5-82  | 6  | 6-72 | 6  |     |
| 7  |                 | 7  |                 | 7  |      | 7  |       | 7  |      | 7  |     |
| 8  |                 | 8  |                 | 8  |      | 8  | 6-51  | 8  |      | 8  |     |
| 9  |                 | 9  |                 | 9  |      | 9  |       | 9  |      | 9  |     |
| 10 |                 | 10 |                 | 10 |      | 10 | 2-3   | 10 |      | 10 |     |
| 11 | RD3-1<br>DZ220  | 11 | 4-61            | 11 |      | 11 |       | 11 |      | 11 | 6-4 |
| 12 |                 | 12 | 4-62            | 12 |      | 12 |       | 12 |      | 12 | 7-4 |
| 13 | RD1-2<br>DF220  | 13 | 4-63            | 13 |      | 13 |       | 13 |      | 13 | 8-4 |
| 14 |                 | 14 | 5-61            | 14 |      | 14 |       | 14 |      | 14 |     |
| 15 | RD4-1<br>DJZ220 | 15 | 5-62            | 15 |      | 15 | 3-112 | 15 |      | 15 |     |
| 16 |                 | 16 | 5-63            | 16 |      | 16 | 3-113 | 16 |      | 16 |     |
| 17 | 1-2<br>DJF220   | 17 | DY24<br>4-71 18 | 17 |      | 17 | R-2   | 17 |      | 17 |     |
| 18 |                 | 18 | DY24<br>6-71 17 | 18 |      | 18 | 2-21  | 18 |      | 18 |     |

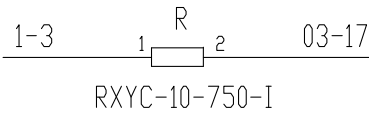

|                       |     |                                    |      |                   |             |           |
|-----------------------|-----|------------------------------------|------|-------------------|-------------|-----------|
| 中铁电气化局黄韩侯铁路（山西段）工程项目部 |     |                                    | 工程名称 | 黄陵-韩城-侯马（山西段）铁路工程 |             |           |
| 制 图 人                 | 张平娟 | 黄陵-韩城-侯马铁路<br>竣工图<br>组合内部配线图(DCA4) |      |                   | 图 号         | 黄韩侯竣信T-08 |
| 审 核 人                 | 王江江 |                                    |      |                   | 比 例         |           |
| 技术负责人                 | 王将涛 |                                    |      |                   | 日 期         | 2012.06   |
| 监理工程师                 | 陈磊林 |                                    |      |                   | 第 1 张 共 1 张 |           |